
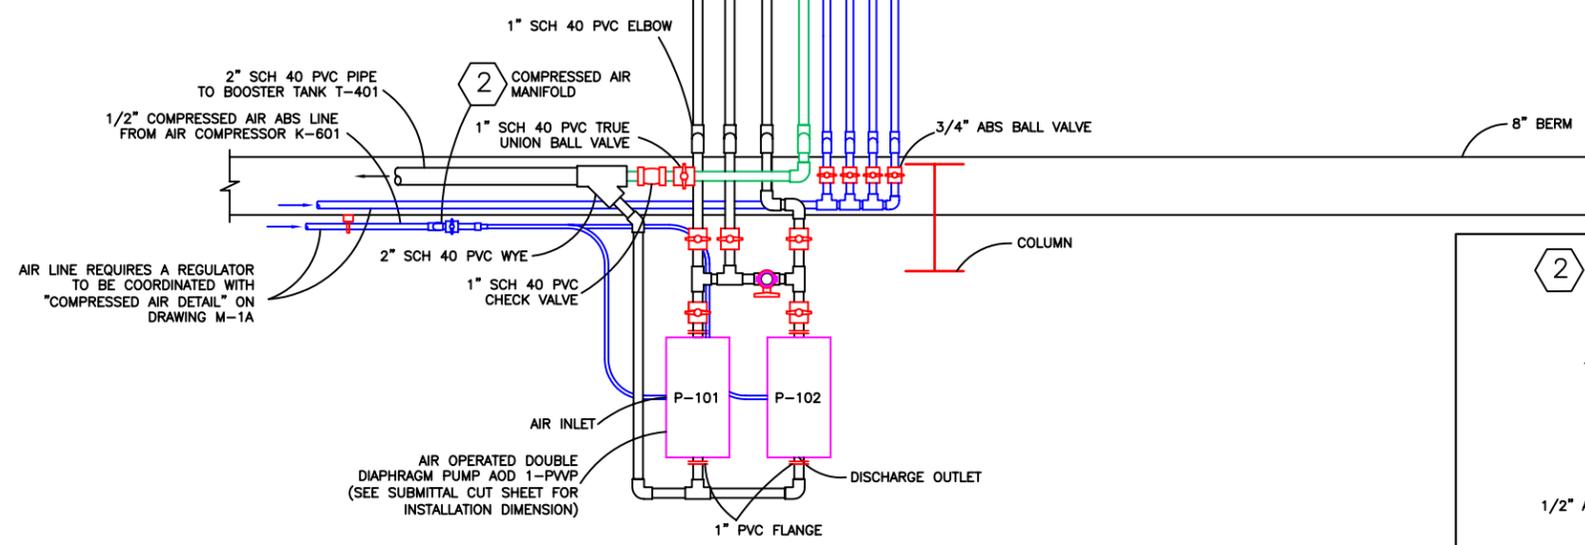
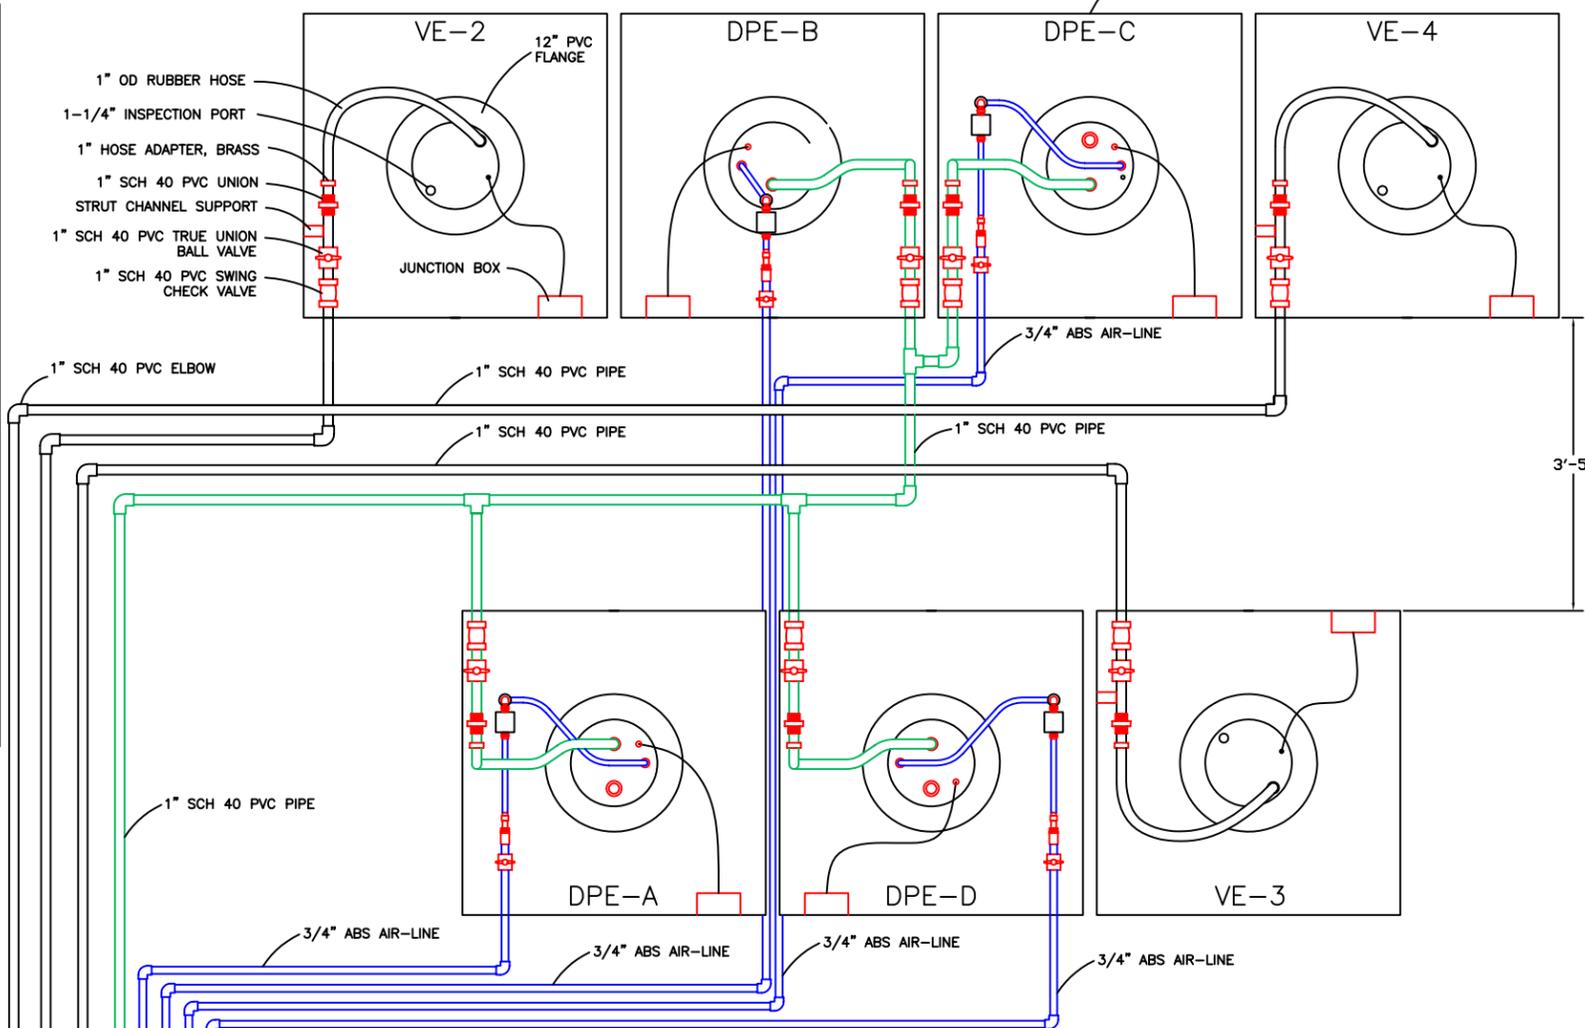



**NOTES:**

1. PLEASE REFER TO C-10A FOR CONDENSATE SUMP DETAIL.

**PUMP CONNECTION DETAIL**  
(NOT TO SCALE)

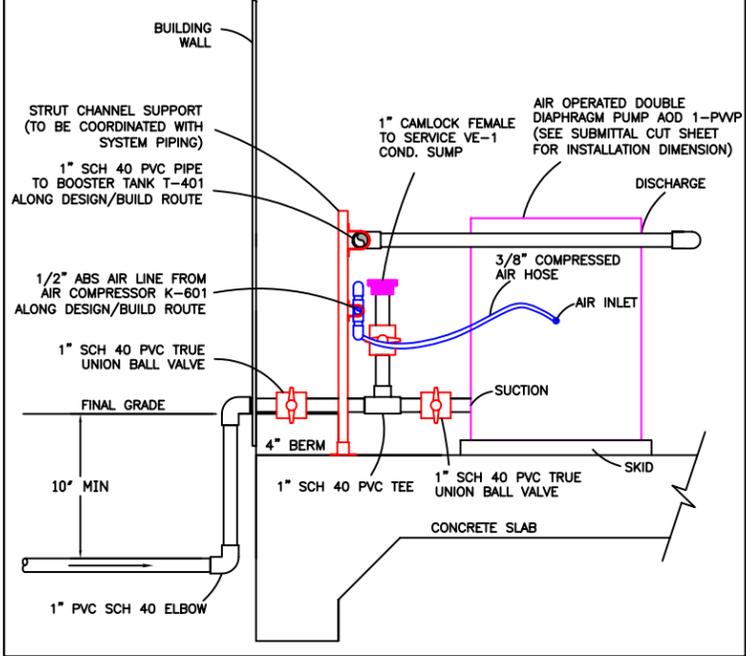

**2 COMPRESSED AIR MANIFOLD**  
(NOT TO SCALE)

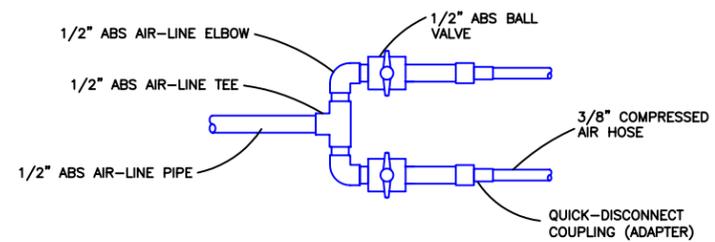

AS-BUILT

**CONDENSATE SUMP MANIFOLD DETAIL**

PEMACO SUPERFUND SITE  
5050 EAST SLAUSON AVENUE  
MAYWOOD, CALIFORNIA

PREPARED FOR: U.S. Environmental Protection Agency Region IX San Francisco, California	PREPARED BY: <b>T N &amp; Associates, Inc.</b> Engineering and Science
SCALE: AS SHOWN	APPROVED: <b>FINAL</b>
DESIGNED: JW & DC	DATE: 07/06/07
DRAWN: DC	DRAWING: C-10C
CHECKED: JW	REV: 6